

JACKSON-MADISON COUNTY
HEALTH DEPARTMENT

745 West Forest Avenue • Jackson, Tennessee 38301-3957
Telephone (901) 423-3020 Fax (901) 424-9559

TONY R. EMSON M.D.
Director

DATE: 1-21-2003

TO: Jack Hall, Madison County Building Commissioner

NAME OF OWNER: Boss Camburan (BAS JAN BUUREN)

ADDRESS:


LOCATION: 63 North Madison Tr. (Lot #'s 7-8, North Madison Park)

RE: Lot evaluation for subsurface sewage disposal system.

LOT IS APPROVED IN ACCORDANCE WITH RESTRICTIONS LISTED BELOW:

NOTE: THIS IS NOT A PERMIT FOR SEPTIC TANK INSTALLATION.

RESTRICTIONS: Requirements for location of house, driveway, etc., and sewage system requirements. A sewage construction permit must be obtained from this Department prior to installation of sewage system. The Health Department must be contacted at the time the system is being installed. The well is to be located a minimum of 50 feet from the septic tank and field lines. Field lines are to be installed at a depth of 28-30 inches unless an exception is made by a representative of the Health Department. See drawing below.

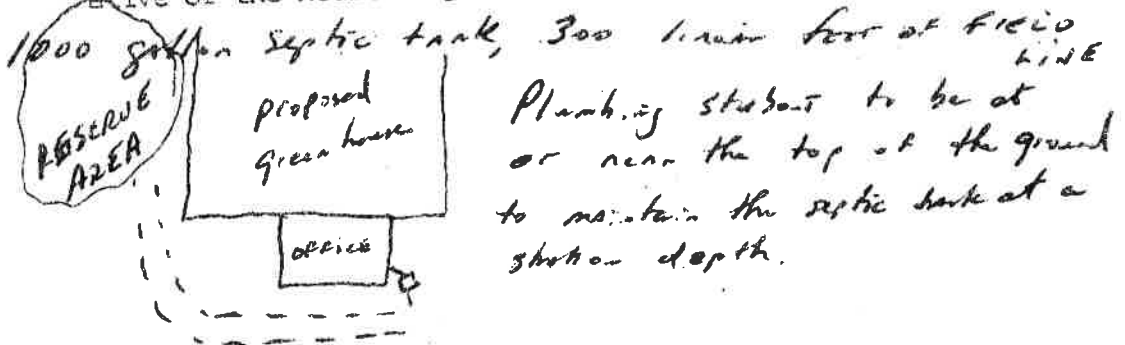

ANY GRADE WORK INVOLVING SOIL REMOVAL OR DISPLACEMENT MAY VOID THIS APPROVAL
VARIATION OF RESTRICTIONS ABOVE VOIDS APPROVAL

LOT APPROVED BY:

45 By Pass
Jane Horner

OWNER OR RECIPIENT'S SIGNATURE